
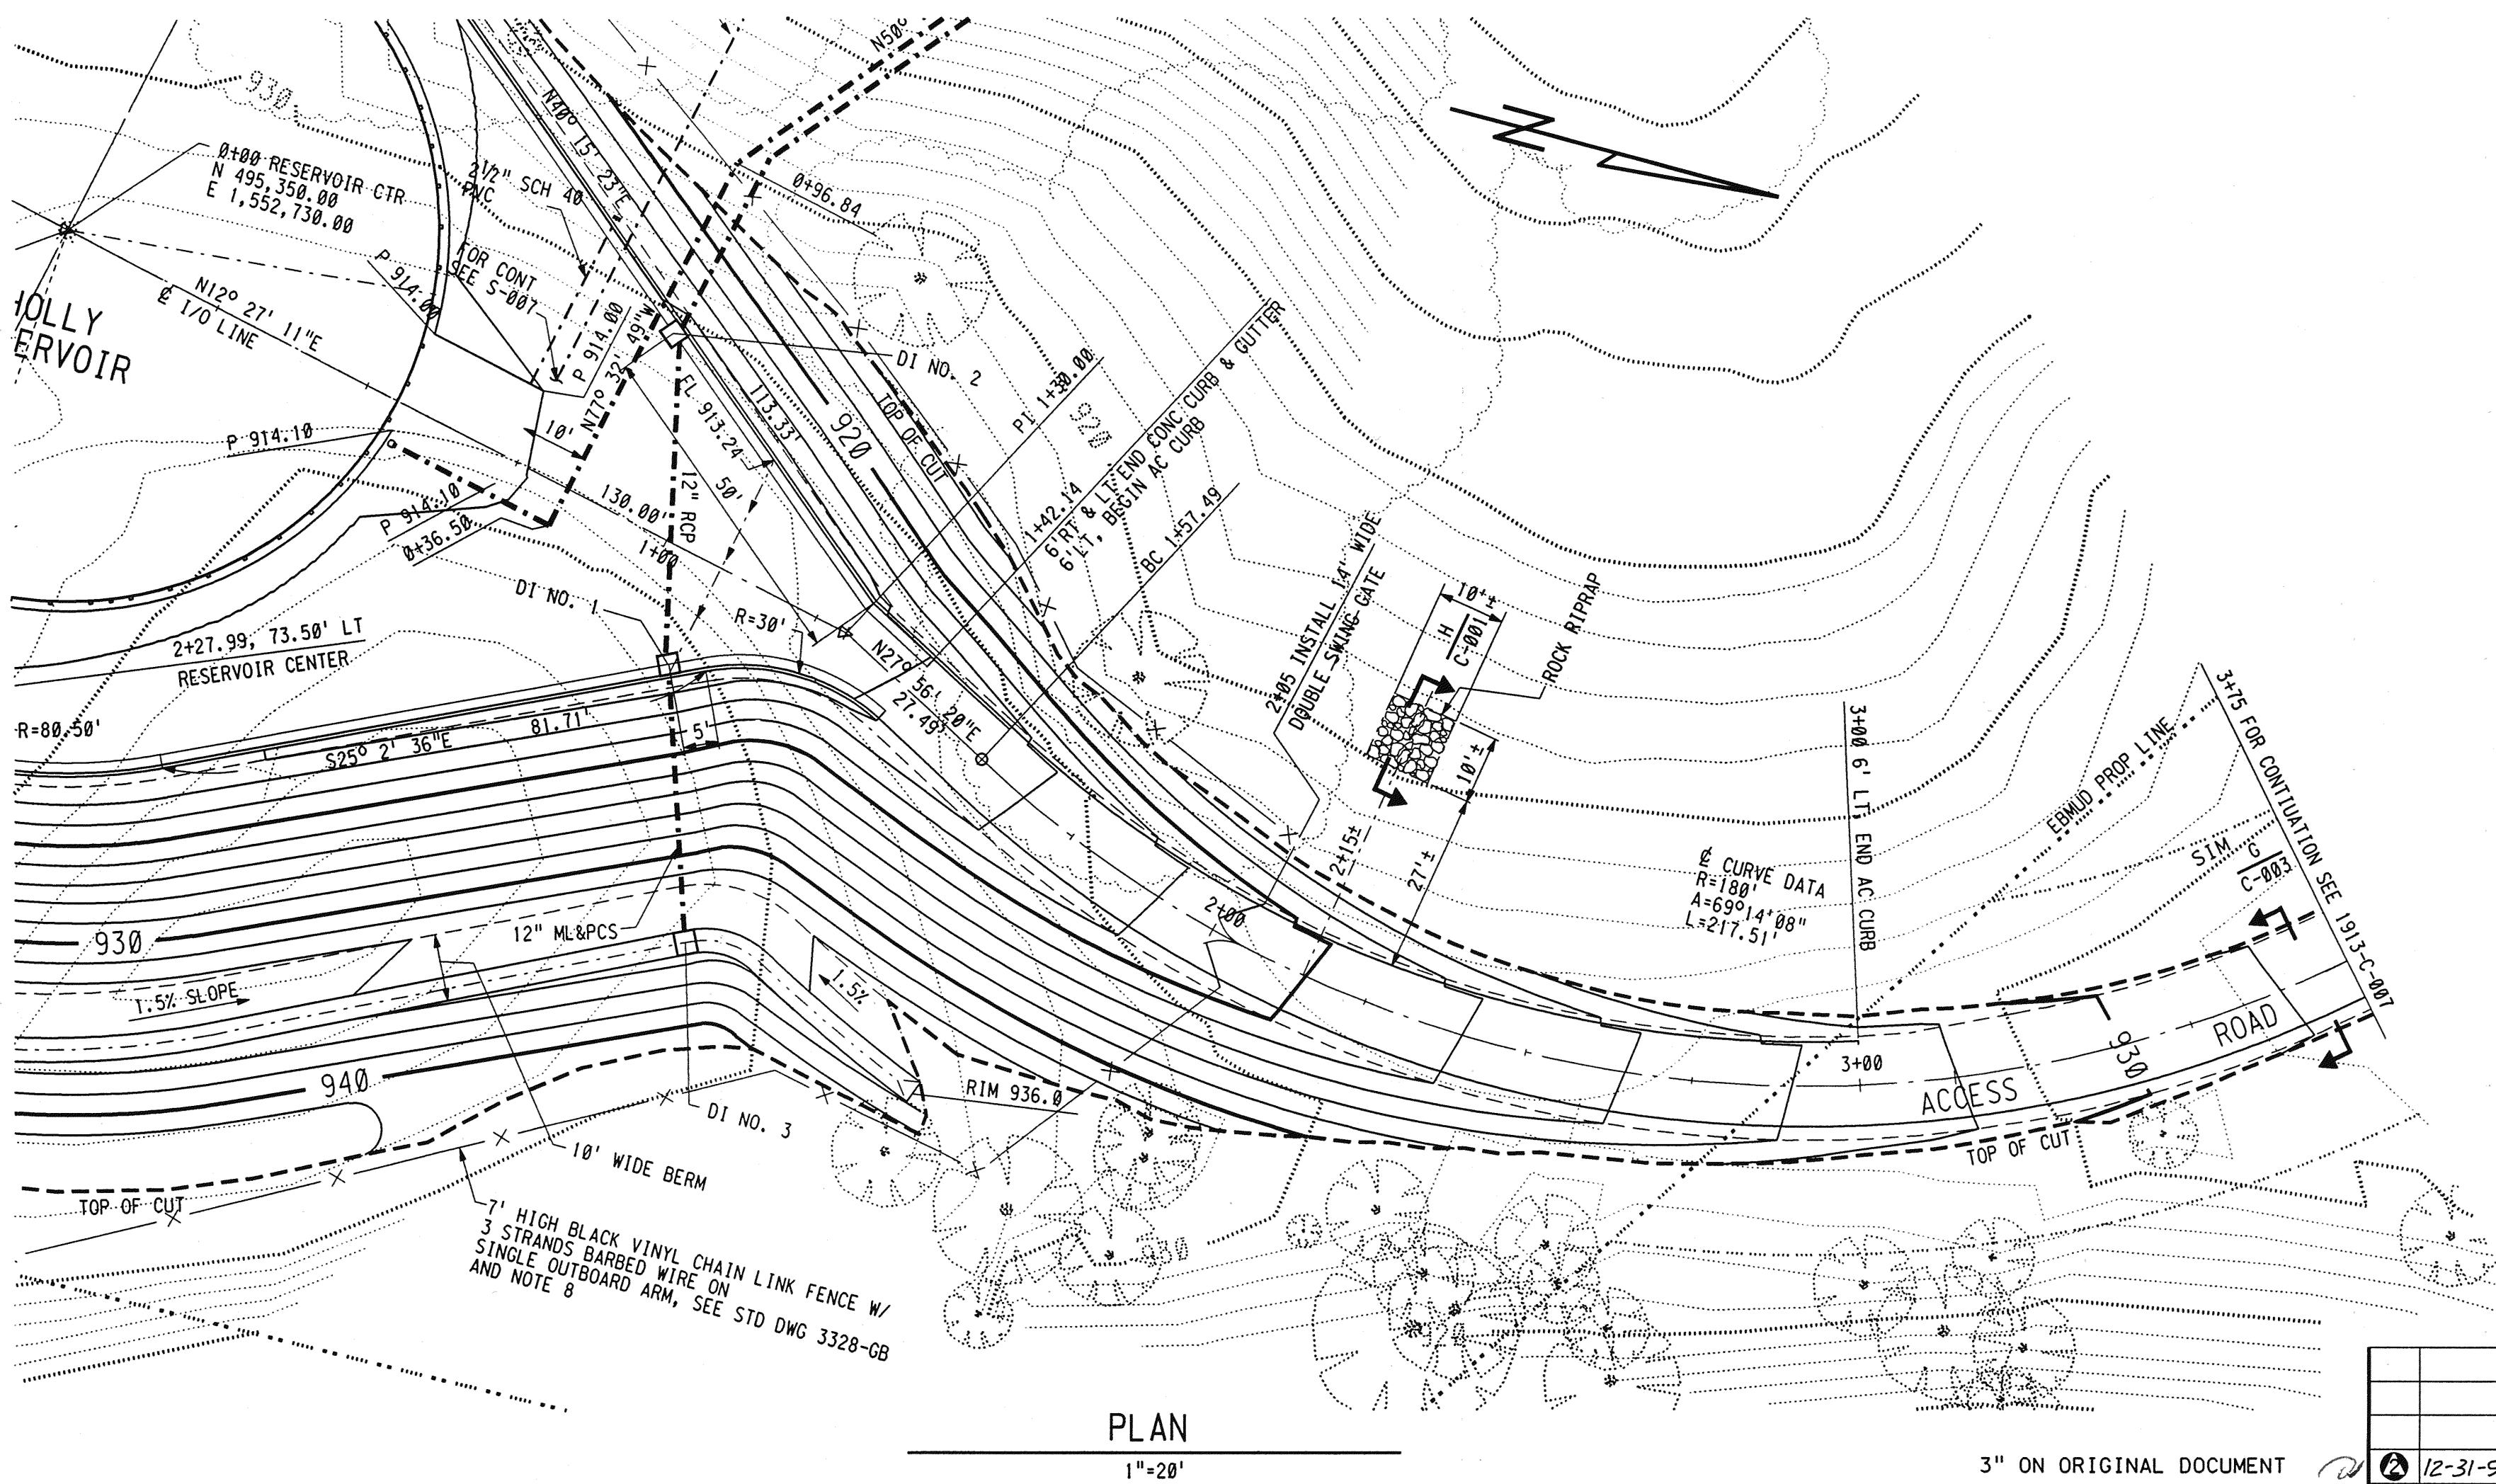


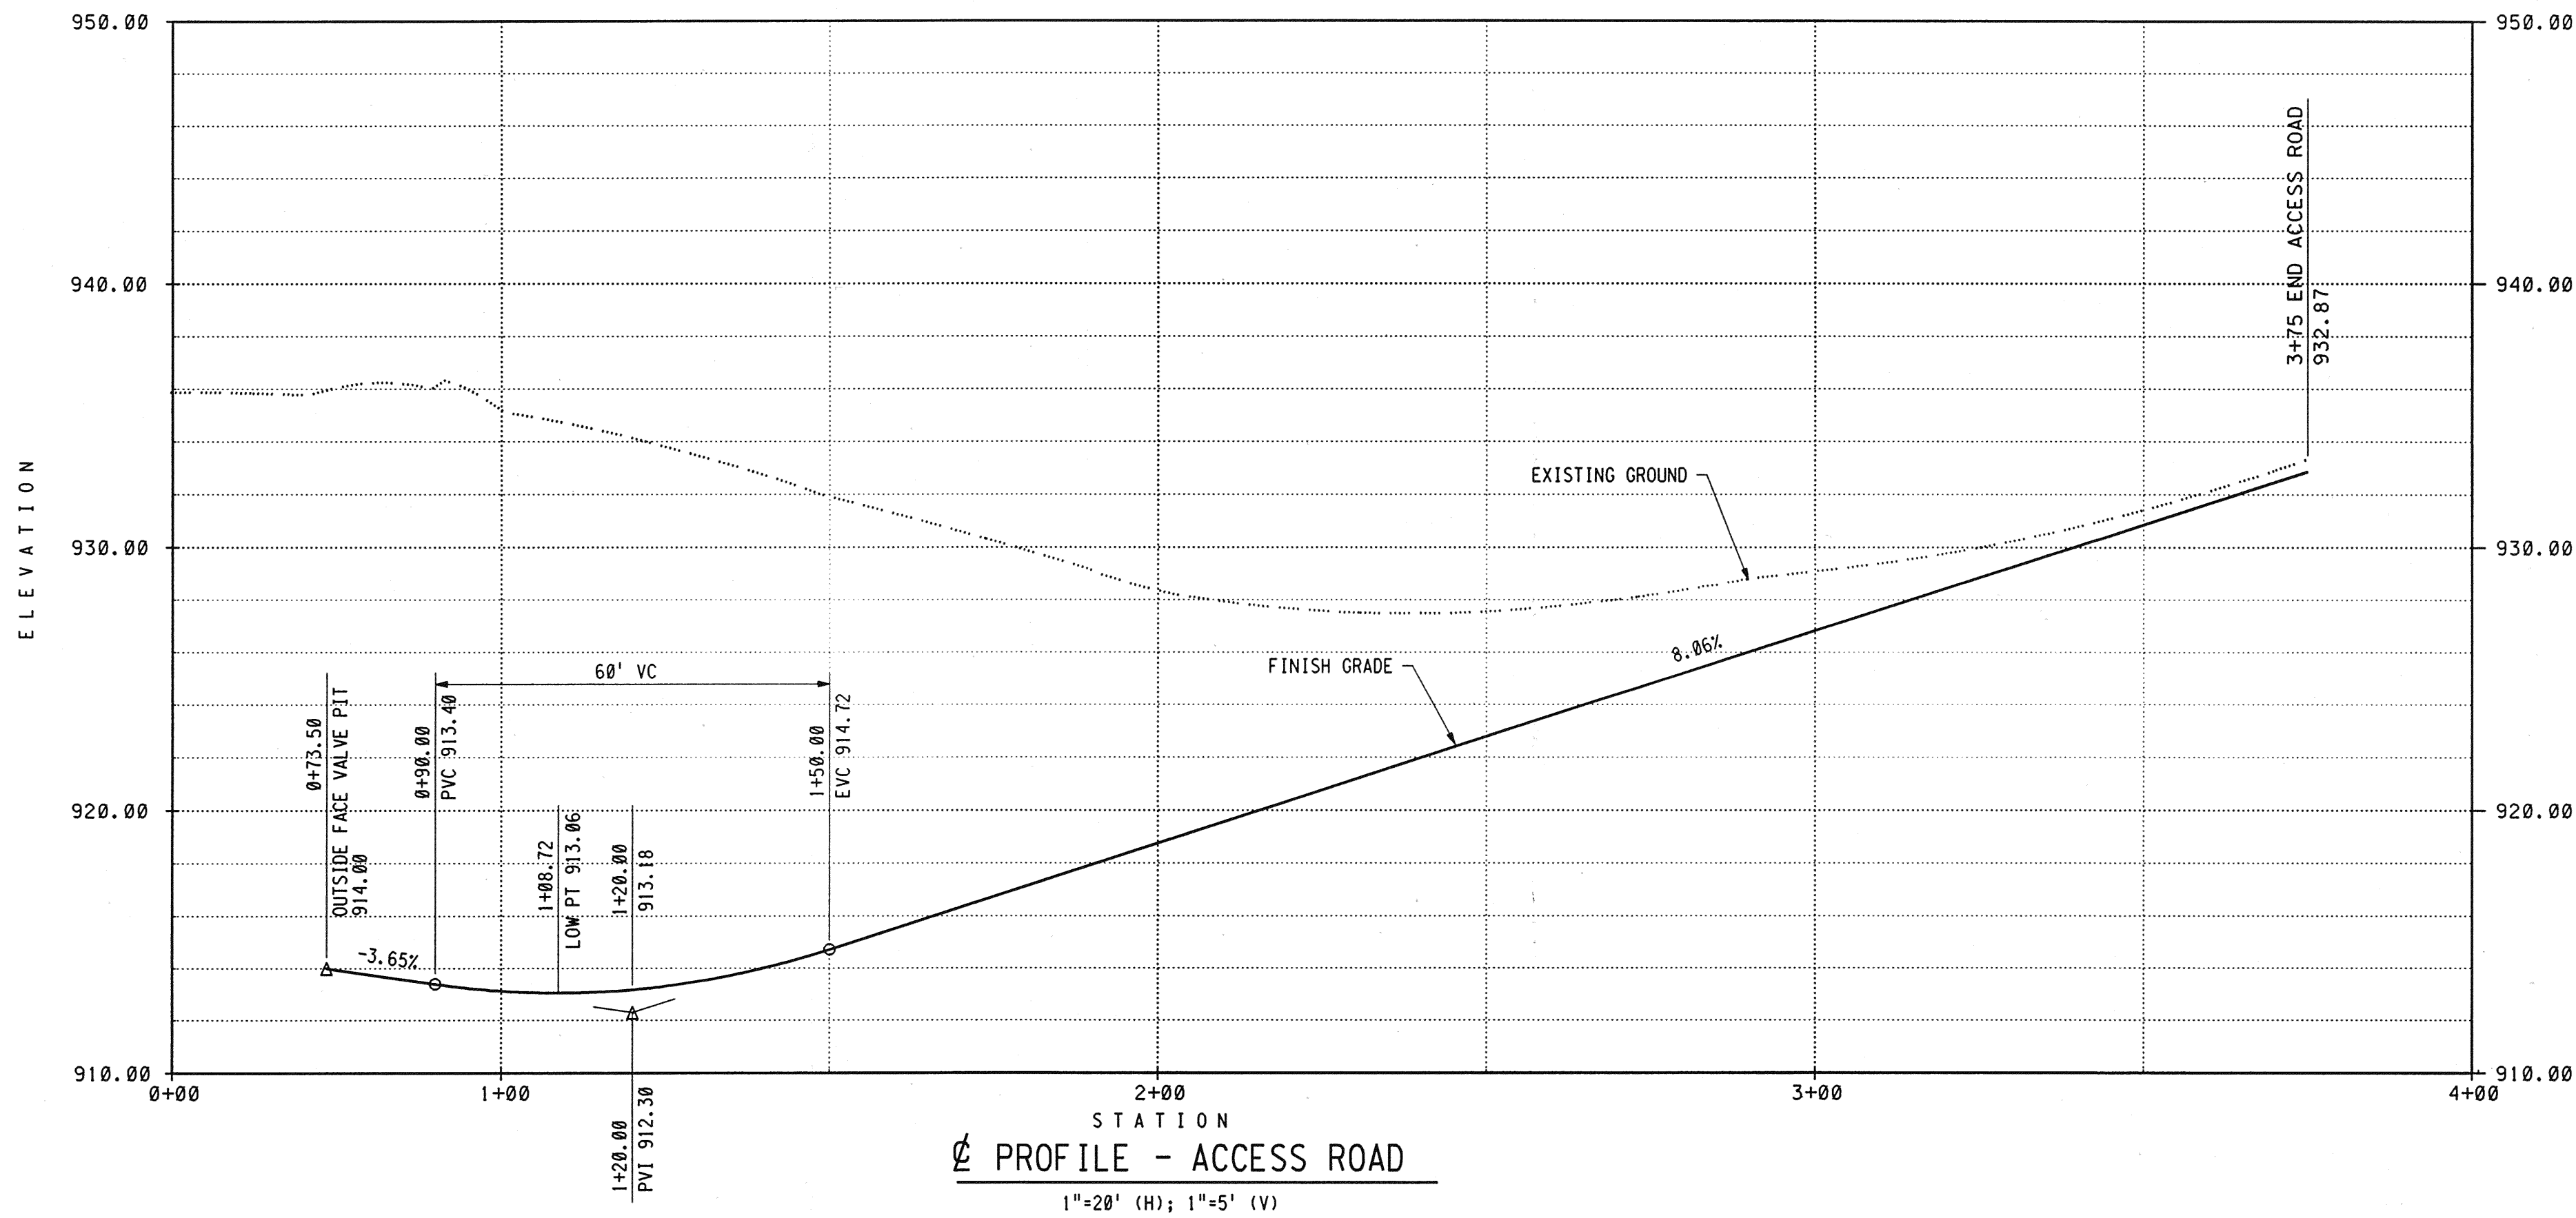

NOTES
 1. NOTES SHOWN ON C-001.

A MICROFILM COPY OF THE ORIGINAL DRAWING WITH ORIGINAL SIGNATURES CAN BE FOUND IN ENGINEERING RECORDS.

DESIGNED BY	S. M. KANEDA
DESIGN CHECKED BY	C. WANG
DRAWN BY	PBC
PROJECT ENGR.	C. WANG
SR. CIVIL ENGR.	J. YOUNG
RECOMMENDED	M. MILLER
APPROVED, DIRECTOR	D. M. DIEMER

EAST BAY MUNICIPAL UTILITY DISTRICT OAKLAND, CALIFORNIA			
HOLLY RESERVOIR 2.1 M.G. STEEL CIVIL ACCESS ROAD PLAN & PROFILE			
PROJECT CODE:	042	1913-C-002	02
SCALE	AS SHOWN		
DATE	02JUL93	STRUCT. DISC.	NUMBER REV.

NO.	DATE	REVISION	BY	REC.	APP.
1	12-31-97	IN SERVICE	AS BUILT		
2	21OCT94	REVISED FENCE LINE & ADDED ROCK RIPRAP	CW	DLP	MLM

PLOT SCALE: 1"=20'
 USER: dlp
 DATE: 28-OCT-1997 12:19
 FILE: /spv1/stor/dist/1913/042c002.1-02