
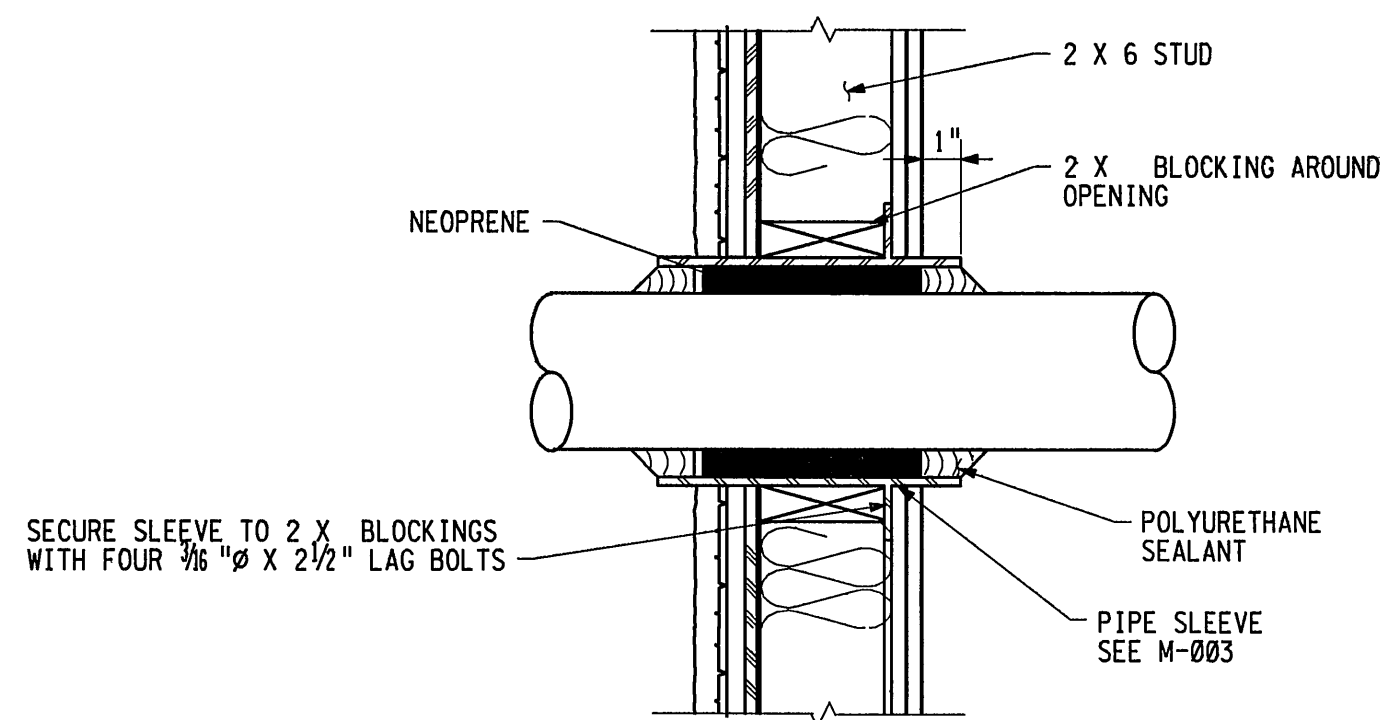
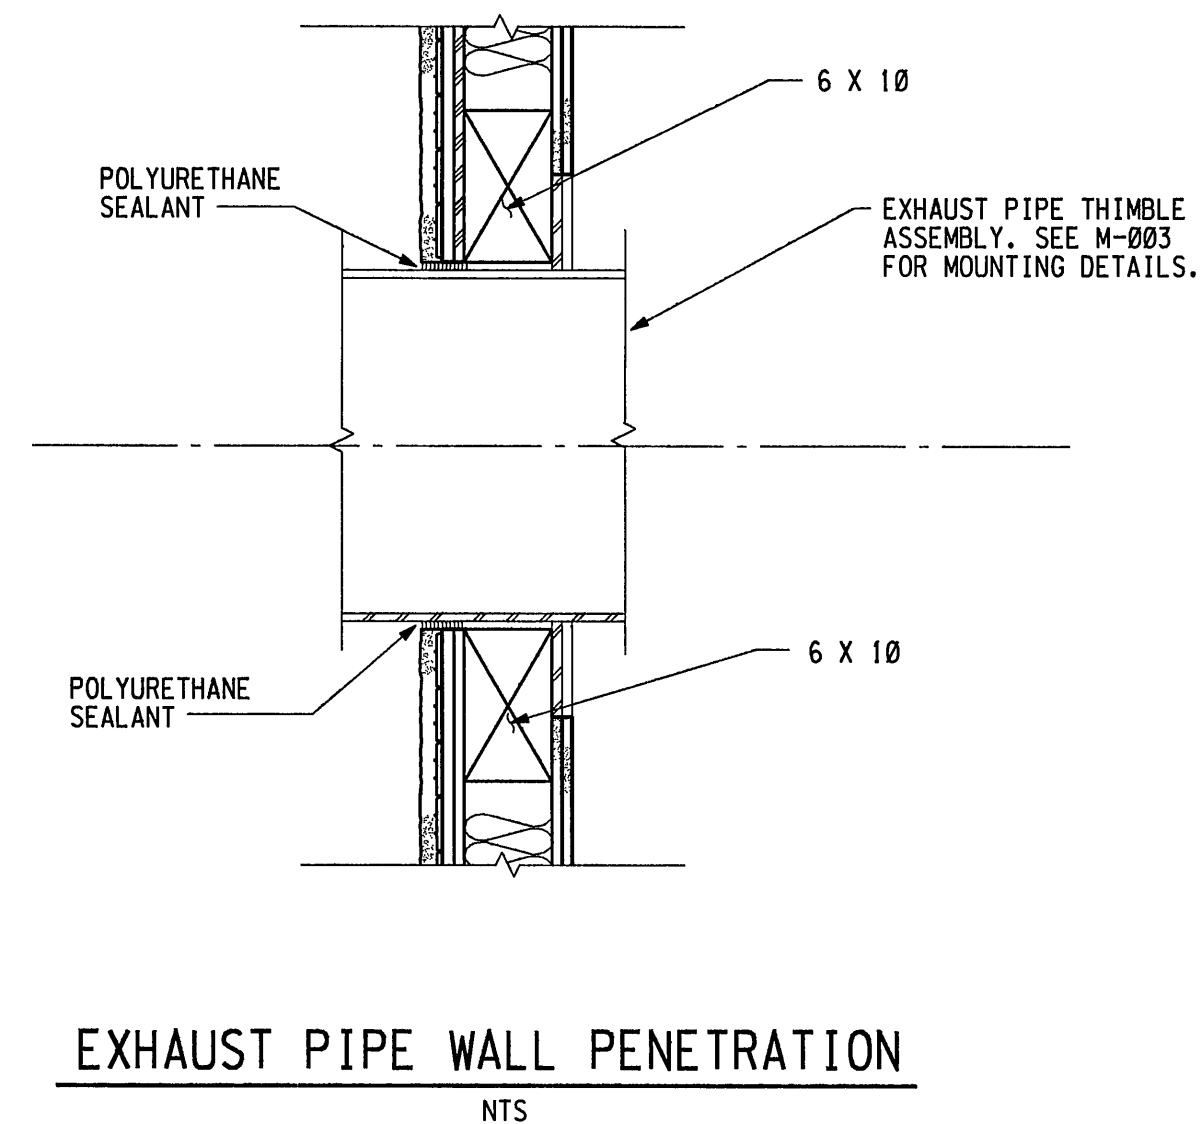
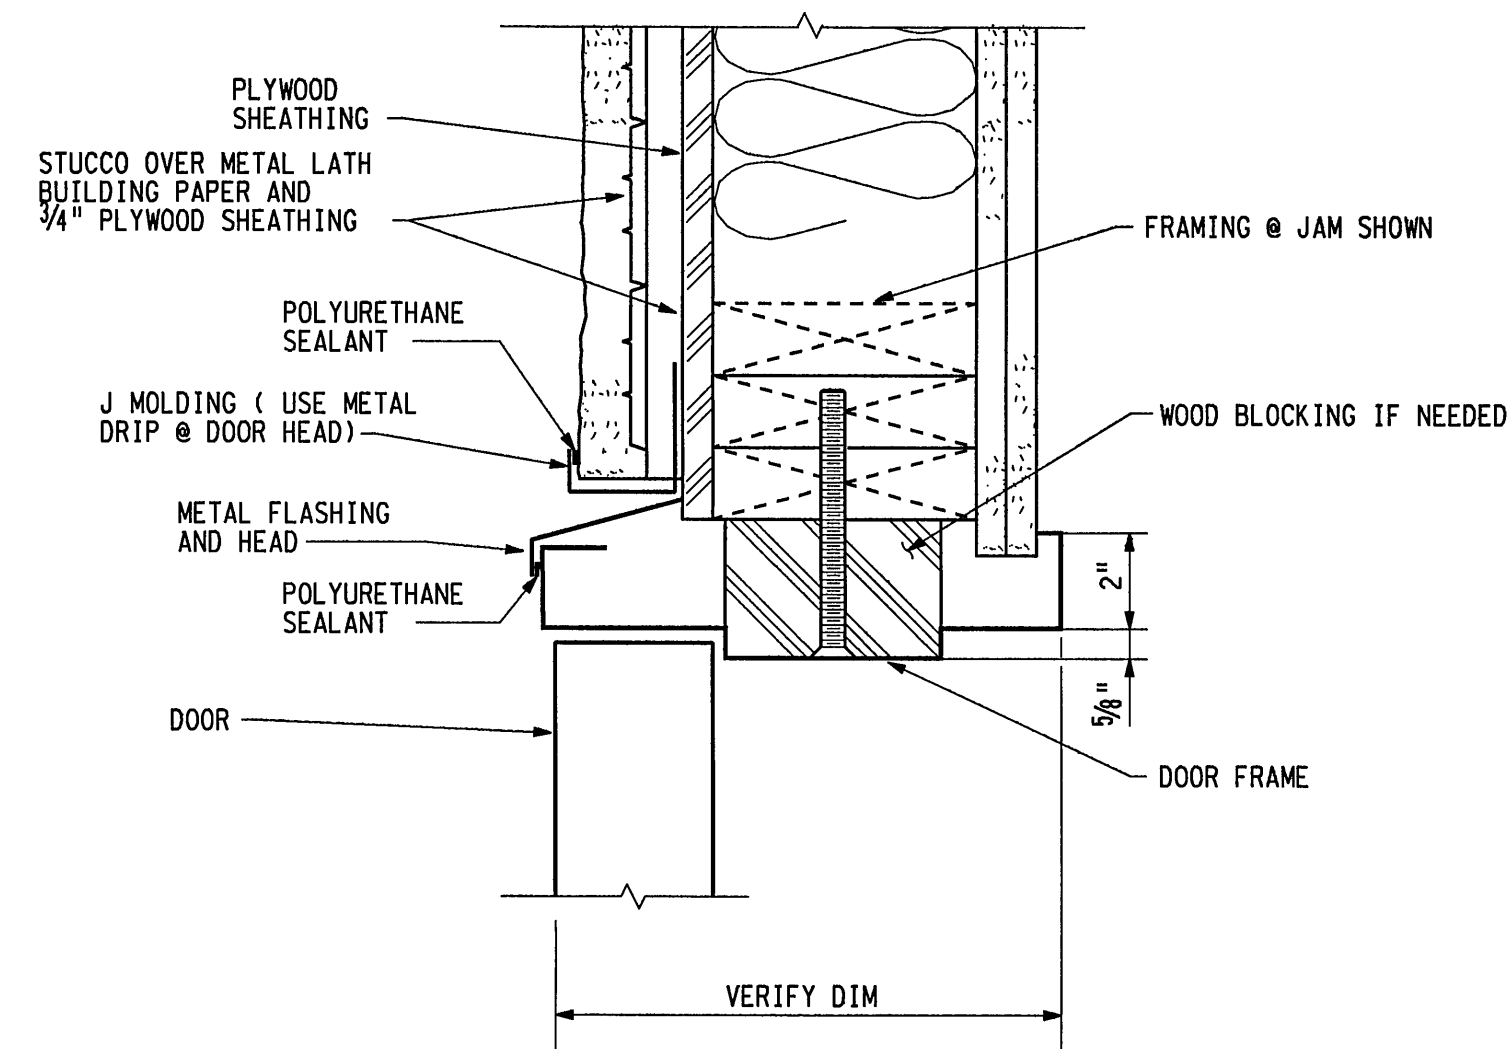
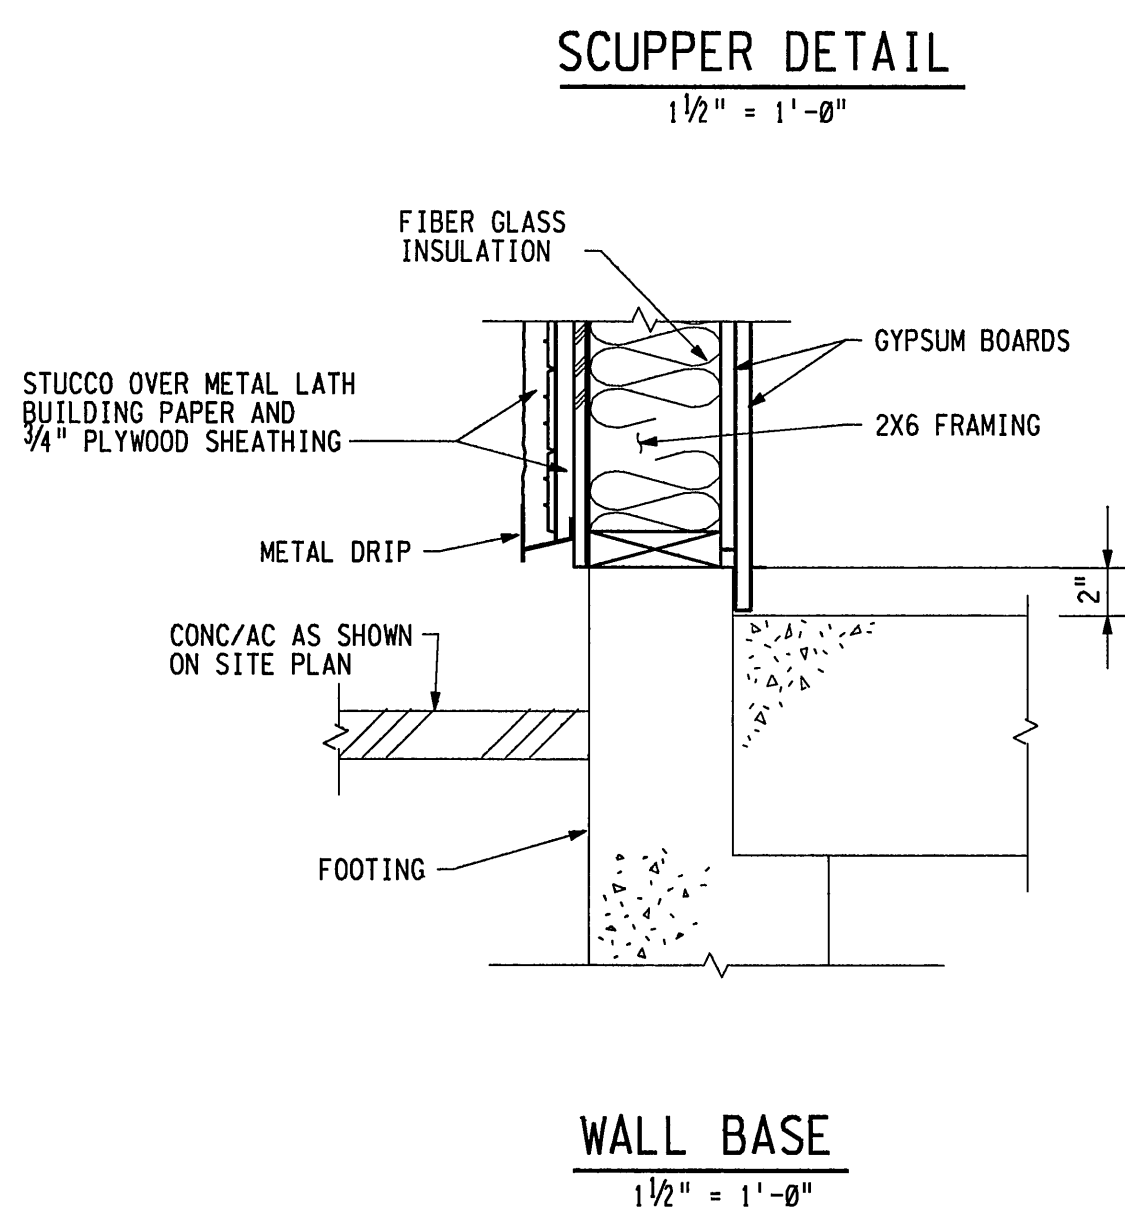
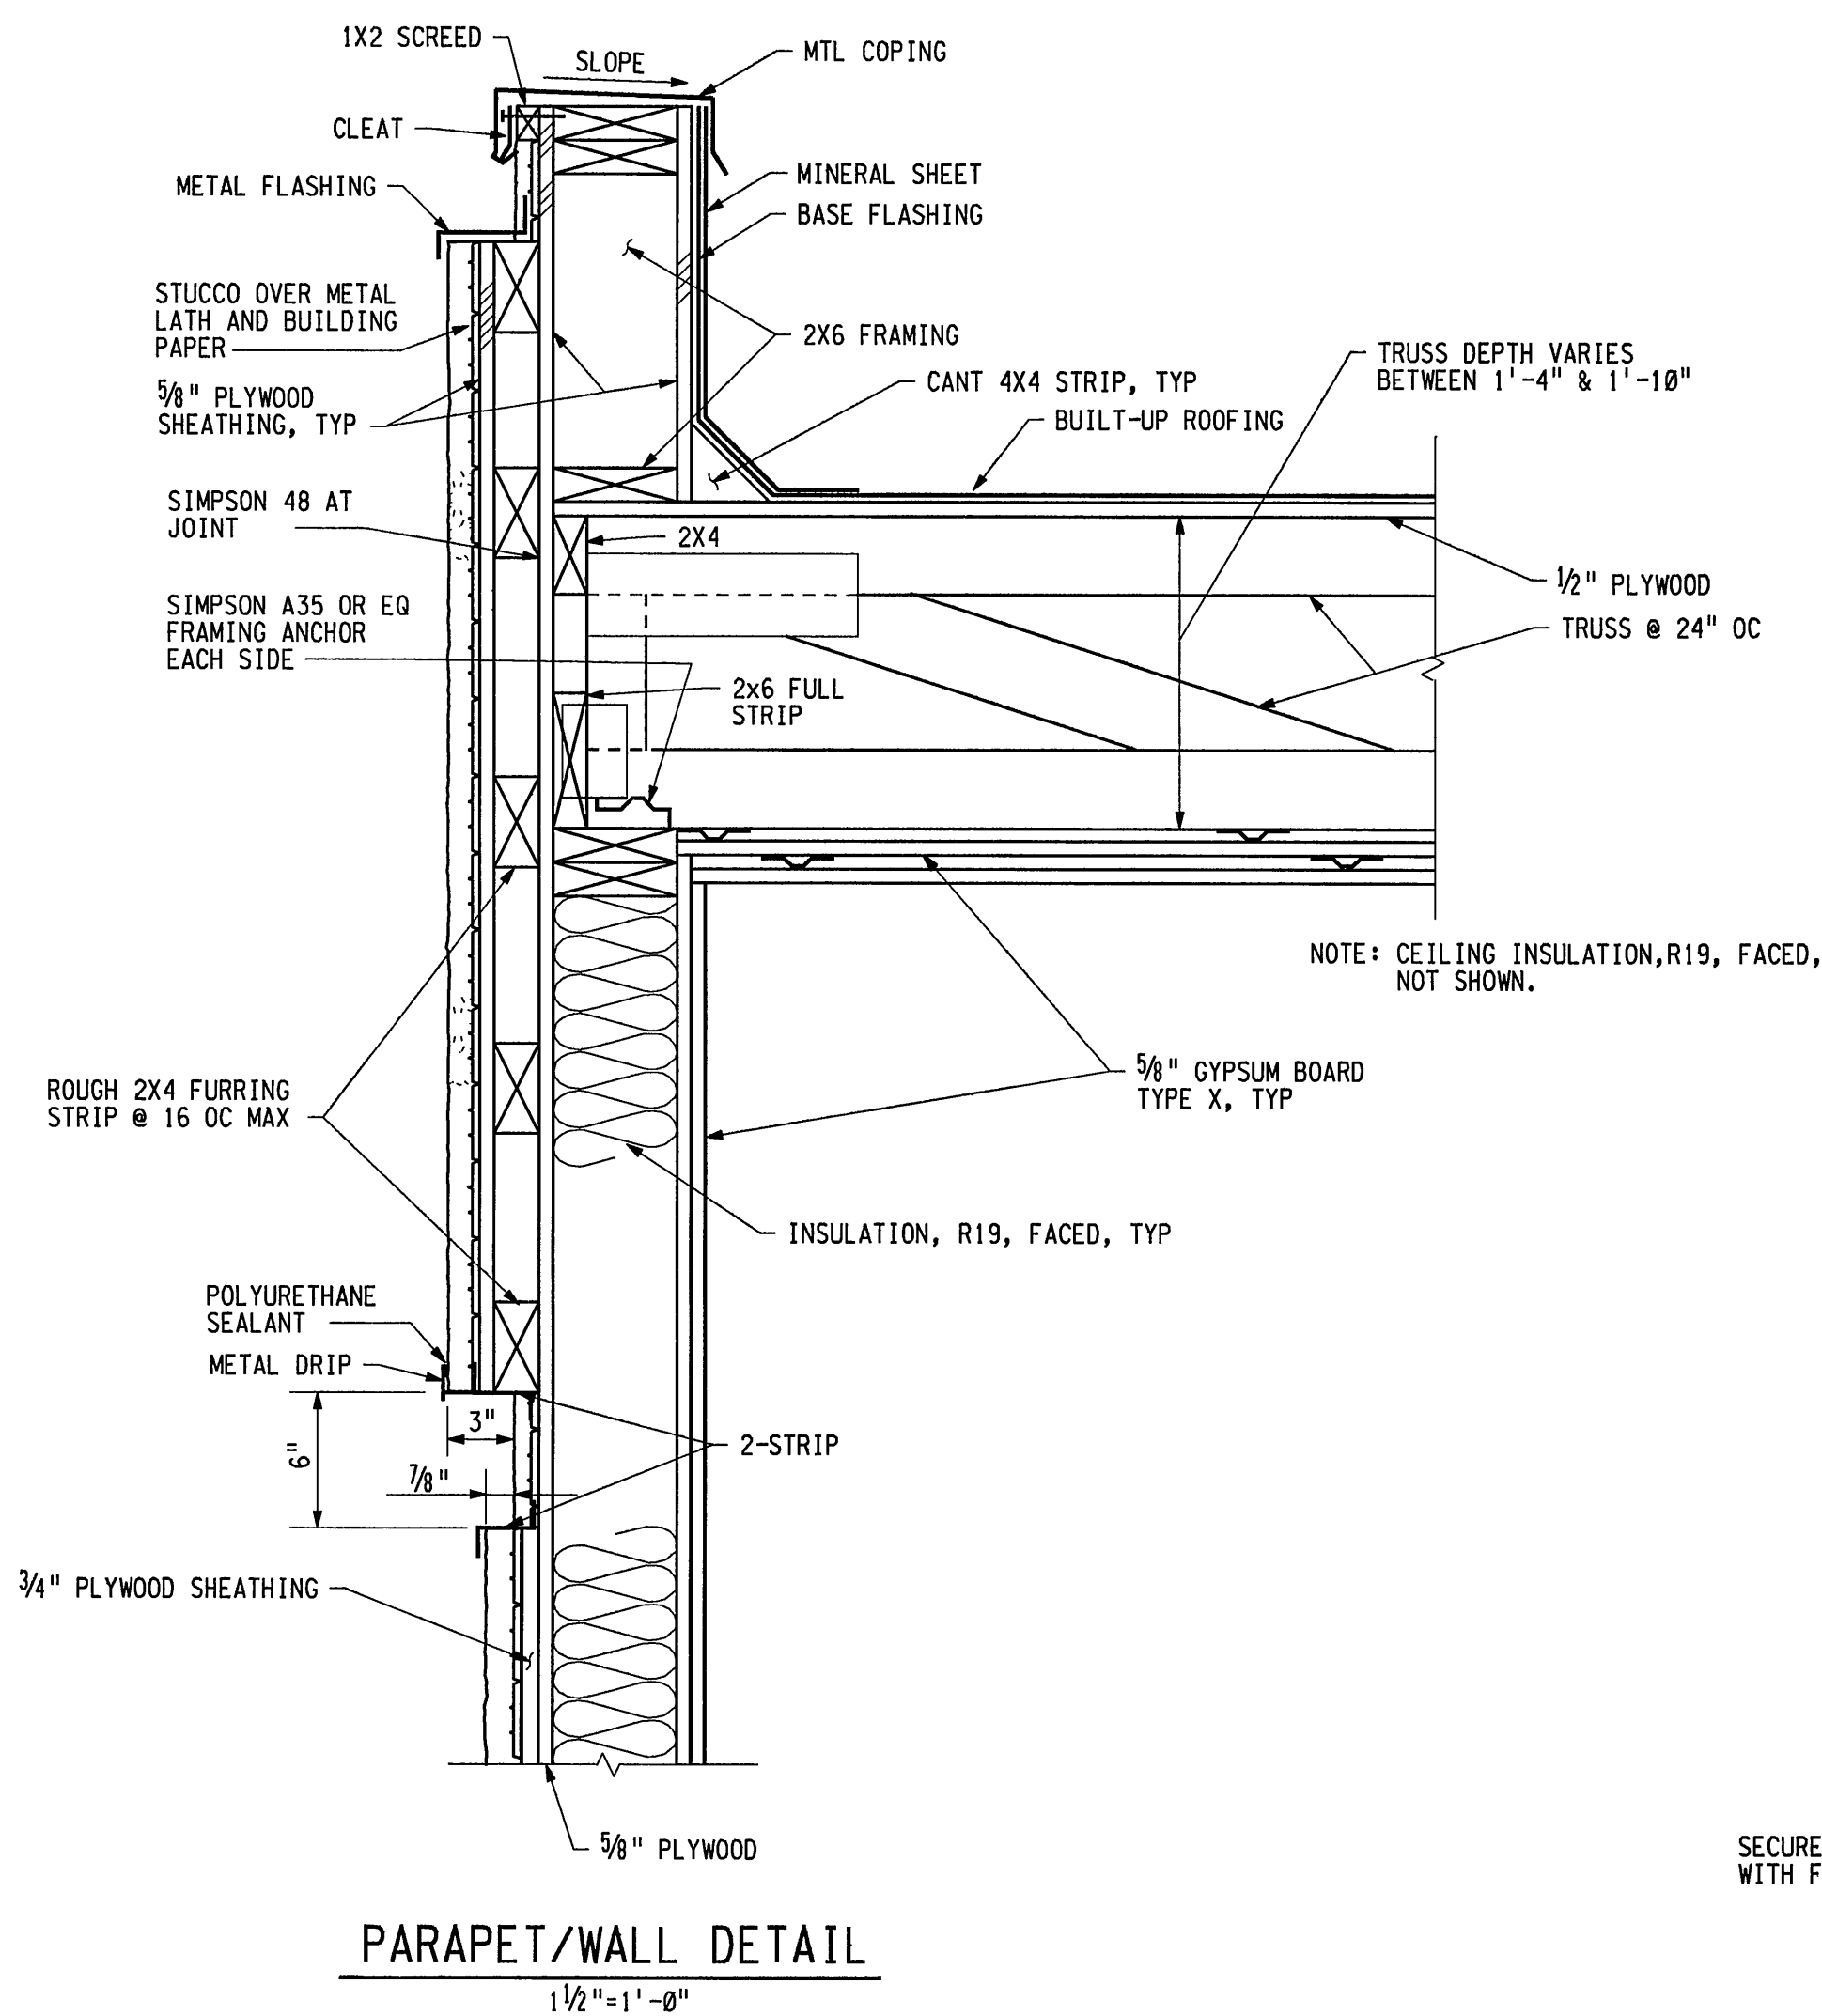
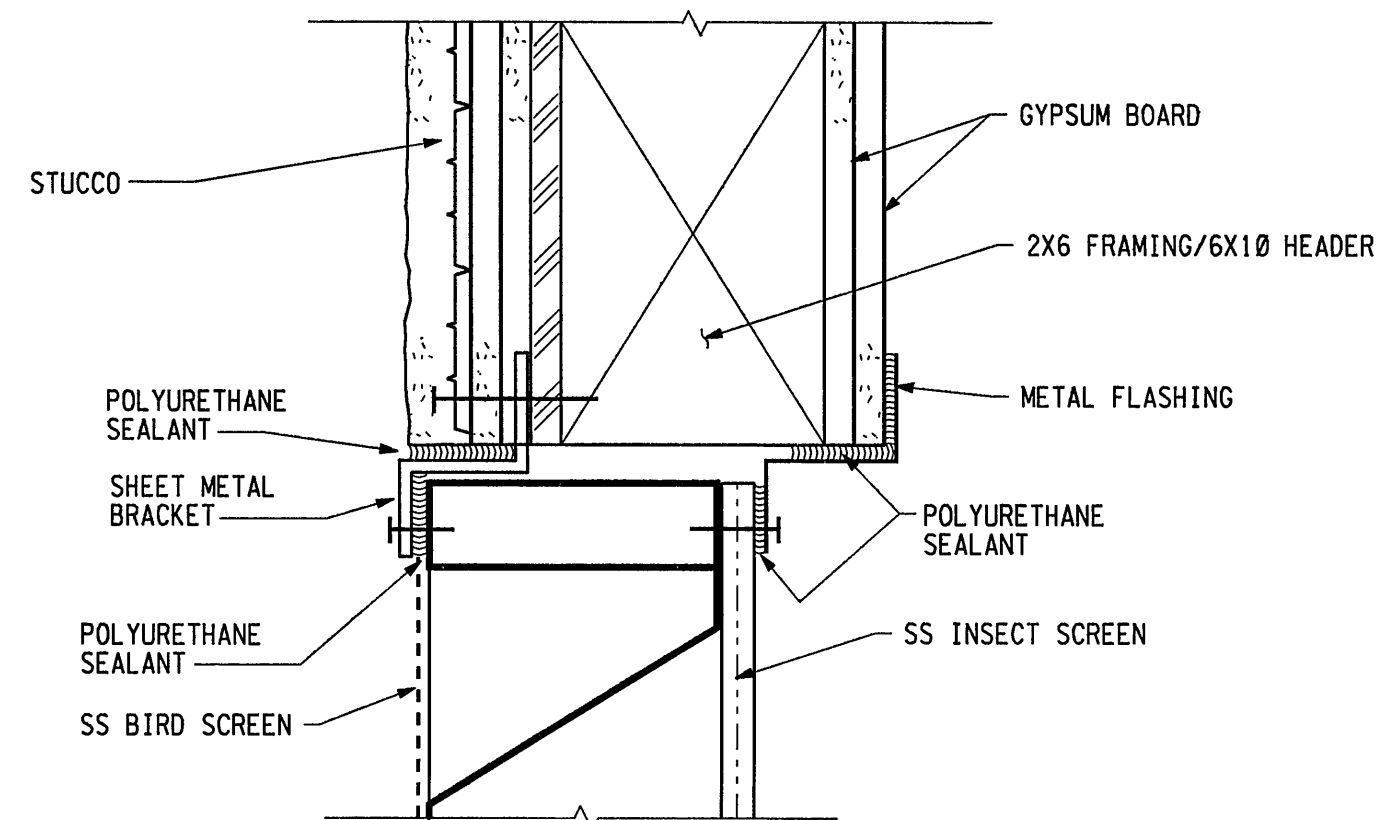
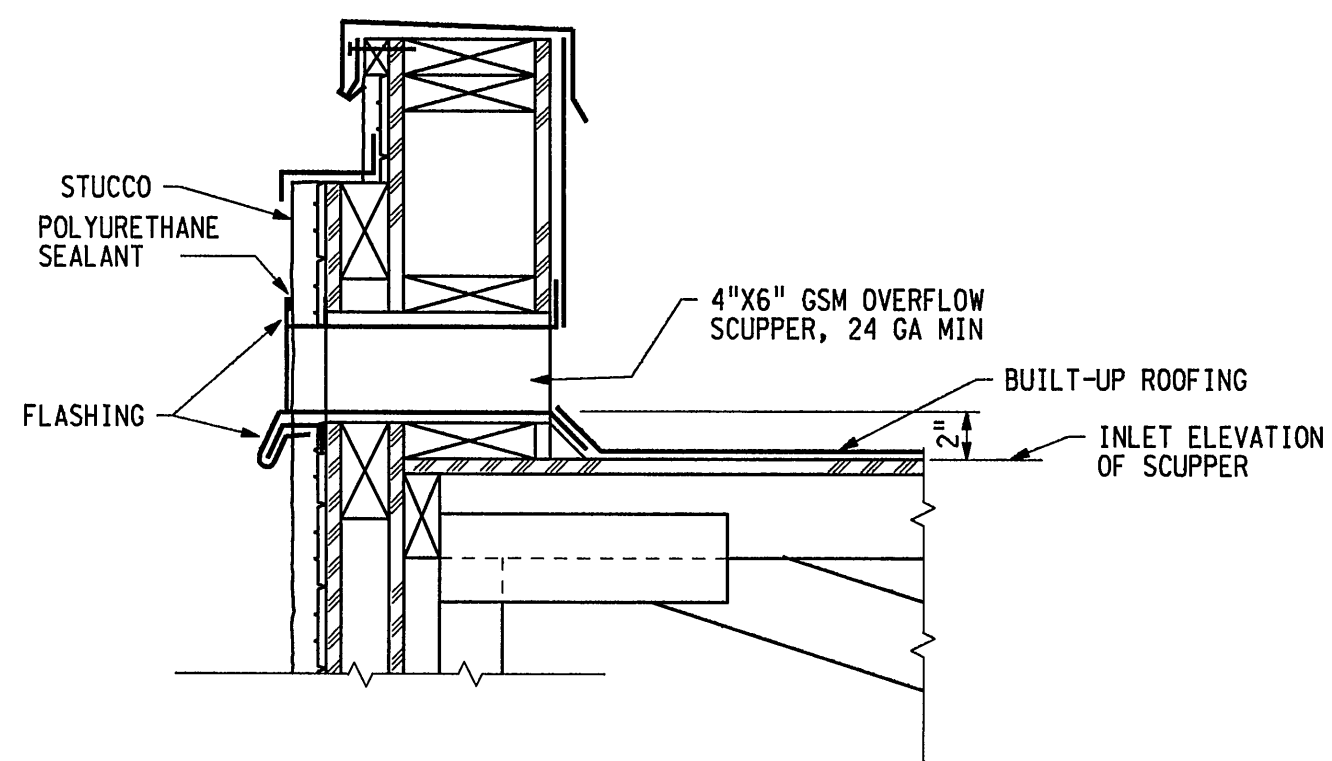
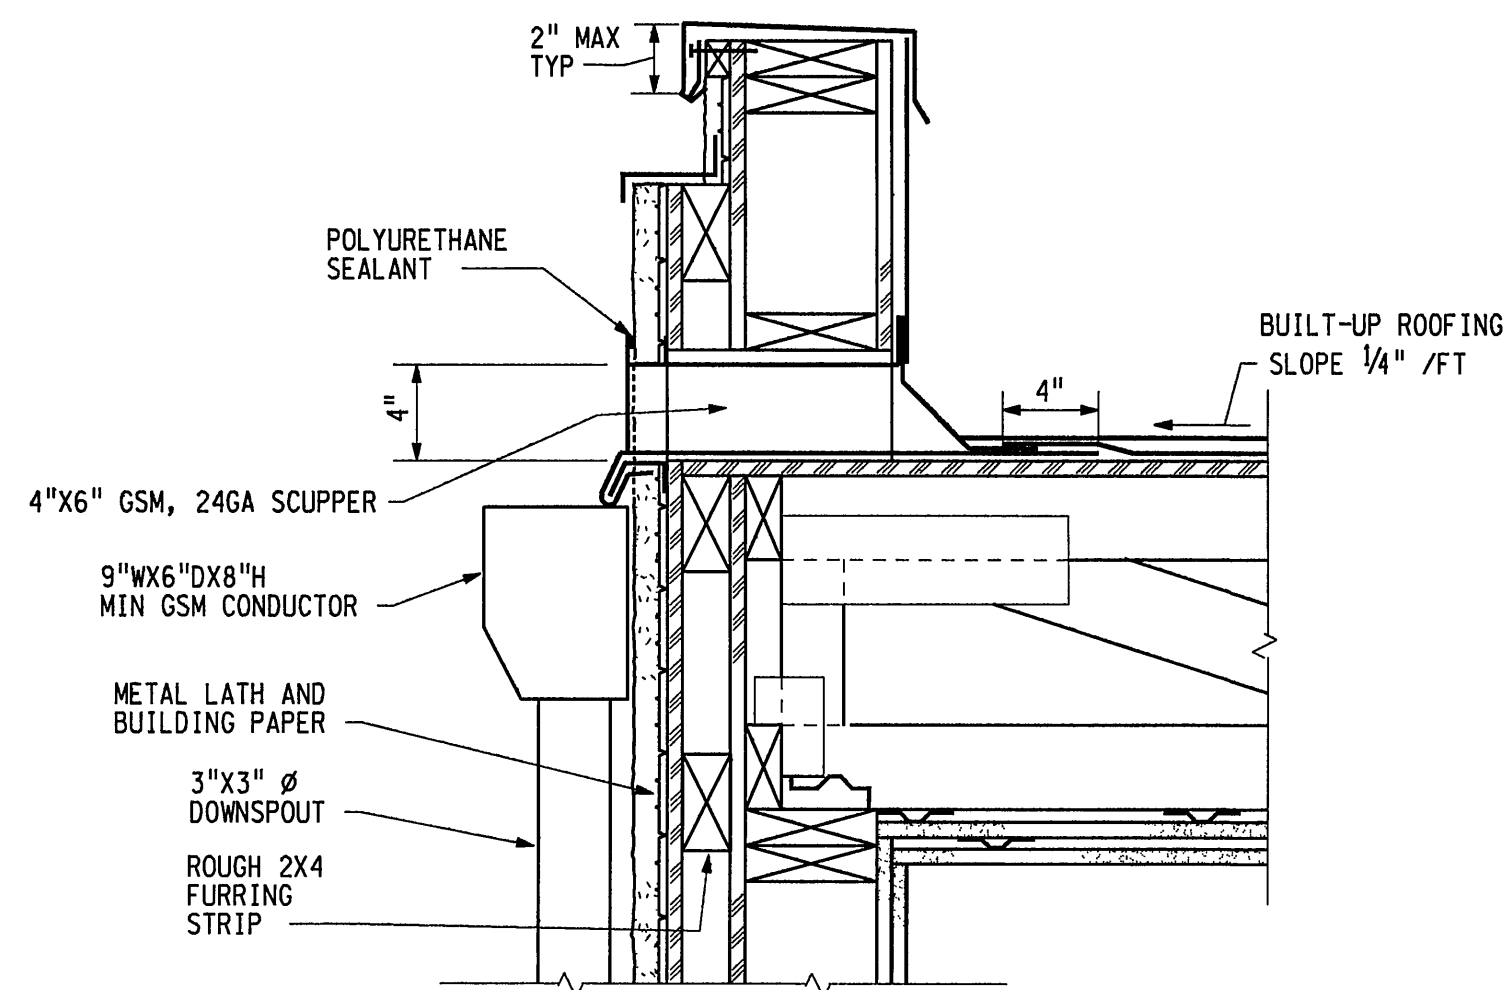


USER: jmw
DATE: 13-JAN-1995 10:39
FILE: /spv1/ttment/sobrante/1002/020s

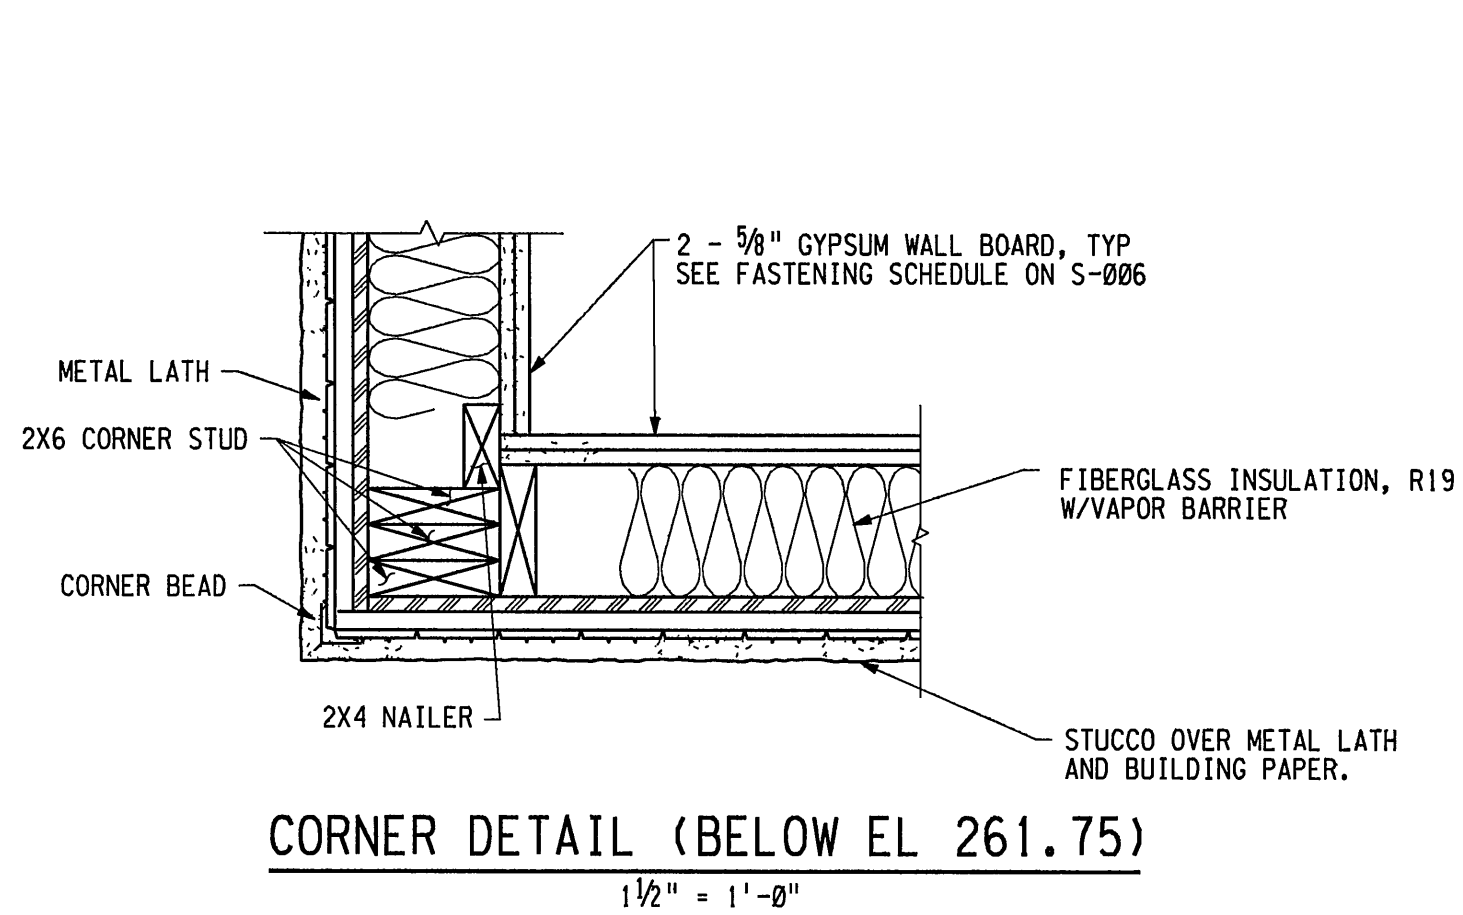

NOTES
1. BUILDING PAPER SHALL BE KRAFT DOUBLE-LAYER PAPER.

A MICROFILM COPY OF THE ORIGINAL DRAWING WITH ORIGINAL SIGNATURES CAN BE FOUND IN ENGINEERING RECORDS.

NO.	DATE	REVISION	BY	REC.	APP.
1	25 JAN 95	IN SERVICE	AS BUILT	INSP.	REV 10
2	15 MAR 93				

DESIGNED BY	R. W. LAU	EAST BAY MUNICIPAL UTILITY DISTRICT OAKLAND, CALIFORNIA			
DESIGN CHECKED BY	C. WANG				
DRAWN BY	J. E. FASQUELLE				
SR. CIVIL ENGR.	JOE YOUNG	SOBRANTE FILTER PLANT EMERGENCY POWER IMPROVEMENTS STRUCTURAL ARCHITECTURAL DETAILS			
PROJECT ENGR.	O. C. BENAVIDEZ				
RECOMMENDED	DES. ALVAREZ	PROJECT CODE:	020	1002-S-004	1
NO. OF DESIGN		SCALE	AS NOTED		
R.P.E. NO. C 22476		DATE	11 MAY 92	STRUCT. DISC.	NUMBER
APPROVED	D.M. DIEMER				
ASST. CHIEF ENGR.					
R.P.E. NO. C 25111					

3" ON ORIGINAL DOCUMENT